Approved as Noted - Returned: 12/02/2011

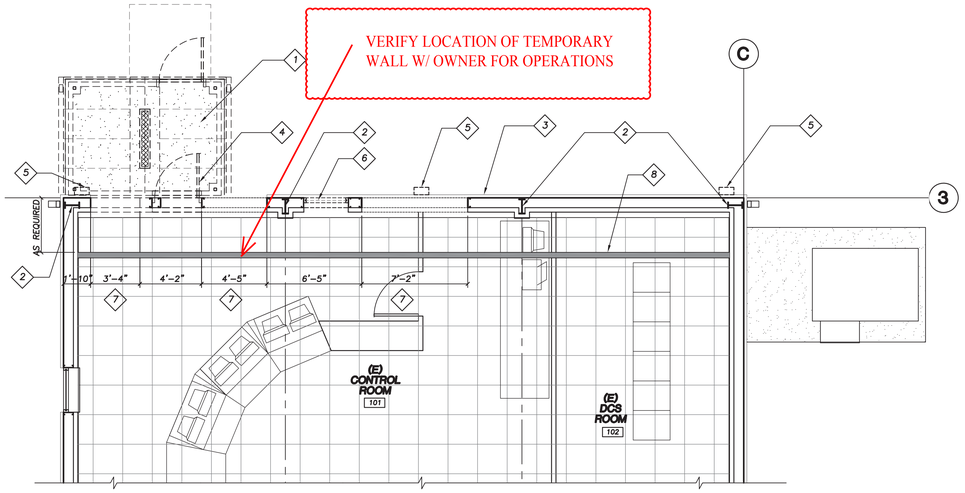

DEMOLITION PLAN 2

SCALE: 3/32"=1'-0"

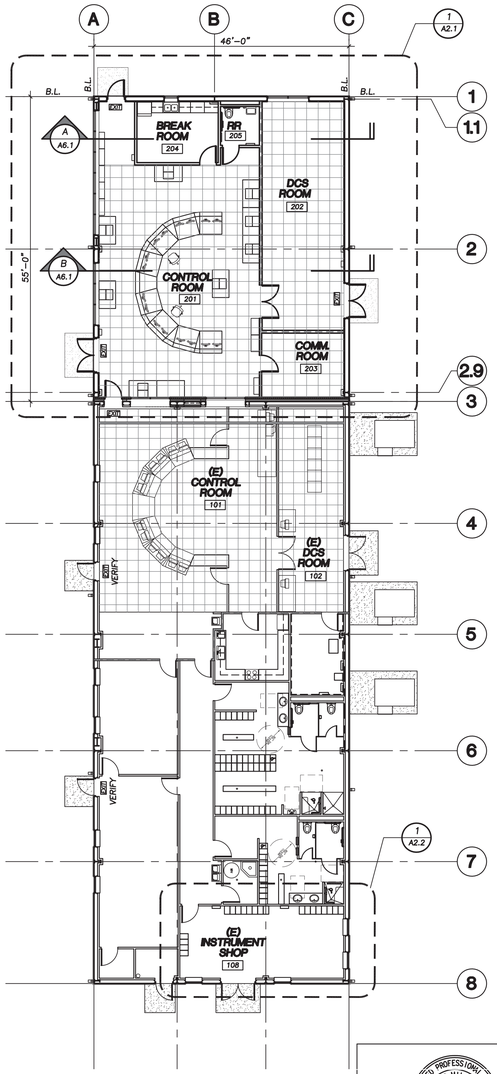

OVERALL FLOOR PLAN 1

SCALE: 3/32"=1'-0"

DEMOLITION KEYNOTES

1. REMOVE EXISTING ROOFING, COLUMNS, DOOR, LIGHTING, CONCRETE LANDING, GUTTERS, DOWNSPOUTS, ETC. RELATED TO THE EXISTING CANOPY
2. EXISTING COLUMNS TO REMAIN
3. REMOVE EXISTING METAL WALL PANELS ALONG EXISTING NORTH WALL
4. REMOVE EXISTING DOOR AND CLOSE OPENING WITH MATERIALS TO COORDINATE WITH NEW CONSTRUCTION ON BOTH SIDES
5. REMOVE EXISTING EXTERIOR WALL MOUNTED LIGHTS
6. REMOVE EXISTING WINDOW
7. REMOVE EXISTING WALL PANELS, STUDS & FINISHES FOR NEW WINDOW AND DOOR
8. CONSTRUCT TEMPORARY WALL FULL HEIGHT OF 400S125-18 STUDS AT 4' O.C. WITH ½" OSB LONG DIRECTION HORIZONTAL ON SOUTH FACE ONLY OVER 6 MIL VISQUEEN. PROVIDE R19 BATT INSULATION BETWEEN STUDS. PROVIDE BRIDGING AT 4' MAX ON CENTER. GLUE OR LAP SPLICES IN VISQUEEN AS REQUIRED TO PROVIDE DUST BARRIER.

LEGEND

- 2 HOUR RATED METAL STUD WALL
- 2 HOUR RATED SHAFT WALL
- NON-RATED METAL STUD PARTITION WALL
- TEMPORARY WALL PER KEYNOTE 8
- B.L. — BUILDING LINE, INSIDE FACE OF PANEL AND EDGE OF SLAB
- ACCESS FLOOR PER DETAIL XX
- EXIT — ILLUMINATED EXIT SIGN PER ELECTRICAL

REV	DESCRIPTION	DWN	CHK	APP	DATE
A	100% SUBMITTAL	BP	JM	–	11.30.11

LOS ANGELES
DEPARTMENT OF WATER AND POWER

HAYNES GENERATING STATION
UNITS 11-16

Kiewit
Kiewit Power
2401 Rayner Boulevard
Lenexa, Kansas 66219

STRUCTURAL ENGINEERS:
J. MILCZEWSKY and ASSOCIATES
3275 E. DATE ST.
BREA, CA. 92823
(714) 335-1289 BUS
(714) 494-8012 FAX

JOB NUMBER 10-048

REGISTERED PROFESSIONAL ENGINEER JURGEN MILCZEWSKY No. S2450 EXP. 3-31-12 STRUCTURAL STATE OF CALIFORNIA

DWP DRAWING NUMBER

CONTROL BUILDING
DEMOLITION & OVERALL FLOOR PLANS

DESIGNED –
DRAWN BAP
CHECKED JAM
APPROVED –

DRAWING NUMBER
A1.1

KIEWIT LOGO SHOULD NOT BE ON DRAWINGS PRODUCED BY OTHERS, TYPICAL ALL DWGS.

990-AR-0001-001 - Packet 990-011 - Haynes 5 & 6 Repowering - 2010017 - Received: 11/22/2011