Approved as Noted - Returned: 12/02/2011

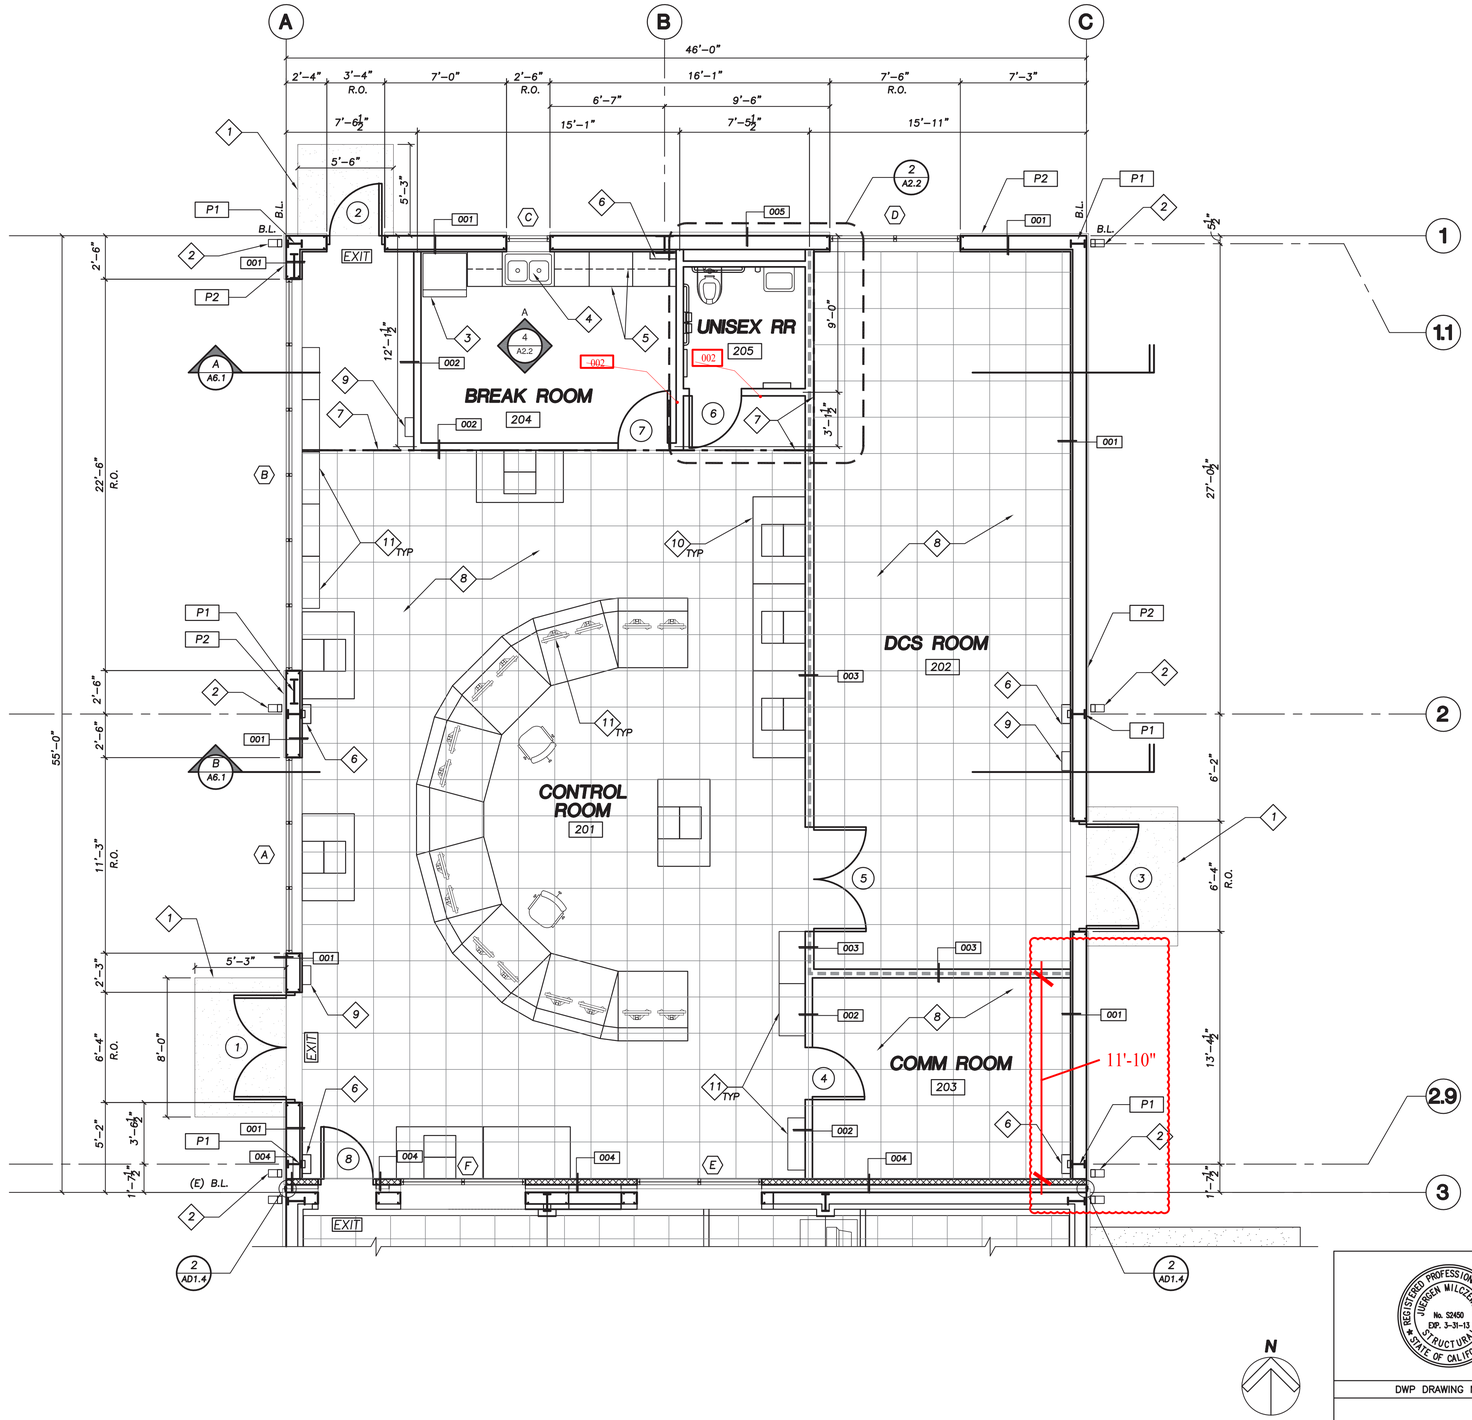

KEYNOTES

1. CONCRETE LANDING AT DOORS TO COMPLY WITH ADA ACCESSIBILITY STANDARDS. SEE AC SHEETS
2. DOWNSPOUT & SPLASHBLOCK PER ROOF PLAN AND EXTERIOR ELEVATIONS
3. REFRIGERATOR BY OWNER
4. STAINLESS STEEL SINK PER PLUMBING WITH DISPOSER
5. PLASTIC LAMINATE BASE & UPPER CASEWORK PER INTERIOR ELEVATIONS
6. FURRED COLUMN
7. LINE OF ACCESS FLOOR
8. ACCESS FLOOR PER DETAILS 5/AD1.2 & SPECIFICATIONS
9. 2A 10BC FIRE EXTINGUISHER, VERIFY LOCATION WITH FIRE INSPECTOR & OWNER
10. FURNITURE BY OTHERS
11. EQUIPMENT BY OTHERS

P.E.M.B. KEYNOTES

- P1 STRUCTURAL STEEL FRAME
- P2 EXTERIOR METAL WALL PANEL
- P3
- P4

LEGEND

- 2 HOUR RATED METAL STUD WALL TO UNDERSIDE OF ROOF STRUCTURE
- 2 HOUR RATED SHAFTWALL
- NON-RATED METAL STUD PARTITION WALL
- ACCESS FLOOR PER DETAIL 5/AD1.2 AND SPECIFICATIONS
- LIMIT OF ACCESS FLOOR
- EXIT — ILLUMINATED EXIT SIGN PER ELECTRICAL
- 1 — DOOR SYMBOL SEE SCHEDULE A7.1
- A — WINDOW SYMBOL SEE SCHEDULE A7.1
- 001 — WALL TYPE SYMBOL SEE AD1.2
- B.L. — BUILDING LINE–INSIDE FACE OF PANEL AND EDGE OF SLAB

REV	DESCRIPTION	DWN	CHK	APP	DATE
A	100% SUBMITTAL	BP	JM	–	11.30.11

LOS ANGELES
DEPARTMENT OF WATER AND POWER

HAYNES GENERATING STATION
UNITS 11-16

Kiewit

Kiewit Power
9401 Renner Boulevard
Lenexa, Kansas 66219

STRUCTURAL ENGINEERS:
J. MILCZEWSKY and ASSOCIATES
3275 E. DATE ST.
BREA, CA. 92823
(714) 335-1289 BUS
(714) 494-8012 FAX

JOB NUMBER 10–048

REGISTERED PROFESSIONAL ENGINEER
JURGEN MILCZEWSKY
No. S2450
EXP. 3-31-13
STRUCTURAL
STATE OF CALIFORNIA

CONTROL BUILDING
ENLARGED FLOOR PLAN

DWP DRAWING NUMBER

DESIGNED –
DRAWN BAP
CHECKED JAM
APPROVED –

DRAWING NUMBER
A2.1

ENLARGED FLOOR PLAN — SCALE: 1/4"=1'-0" — 1

990-AR-0002-001 - Packet 990-011 - Haynes 5 & 6 Repowering - 2010017 - Received: 11/22/2011